

SITE LOCATION MAP

NTS




ISLAND SITE MAP

NTS



INDEX OF DRAWINGS

- FIGURE 1 – SITE LOCATION MAP & DRAWINGS INDEX
- FIGURE 2 – SEPTIC SYSTEM PLAN
- FIGURE 3 – SELECT DETAILS

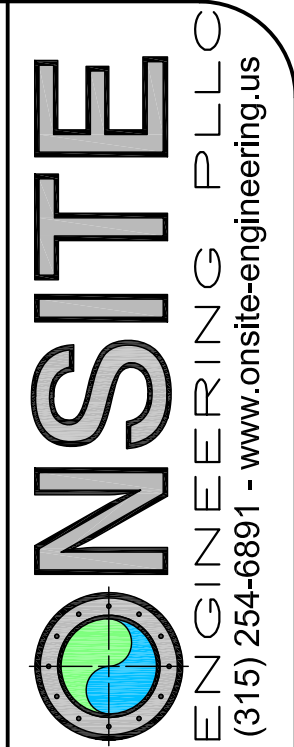



PROJECT LOCATION	YATES RESIDENCE
	ELM TREE ISLAND, HAMMOND, NEW YORK 13646
	TOWN OF HAMMOND – COUNTY OF ST LAWRENCE
OWNER ADDRESS	ELM TREE ISLAND
	HAMMOND, NEW YORK 13646
SITE LOCATION MAP & DRAWINGS INDEX	

FILE NUMBER	EEM2019-060
DATE	9-23-2019
FIGURE NO.	1

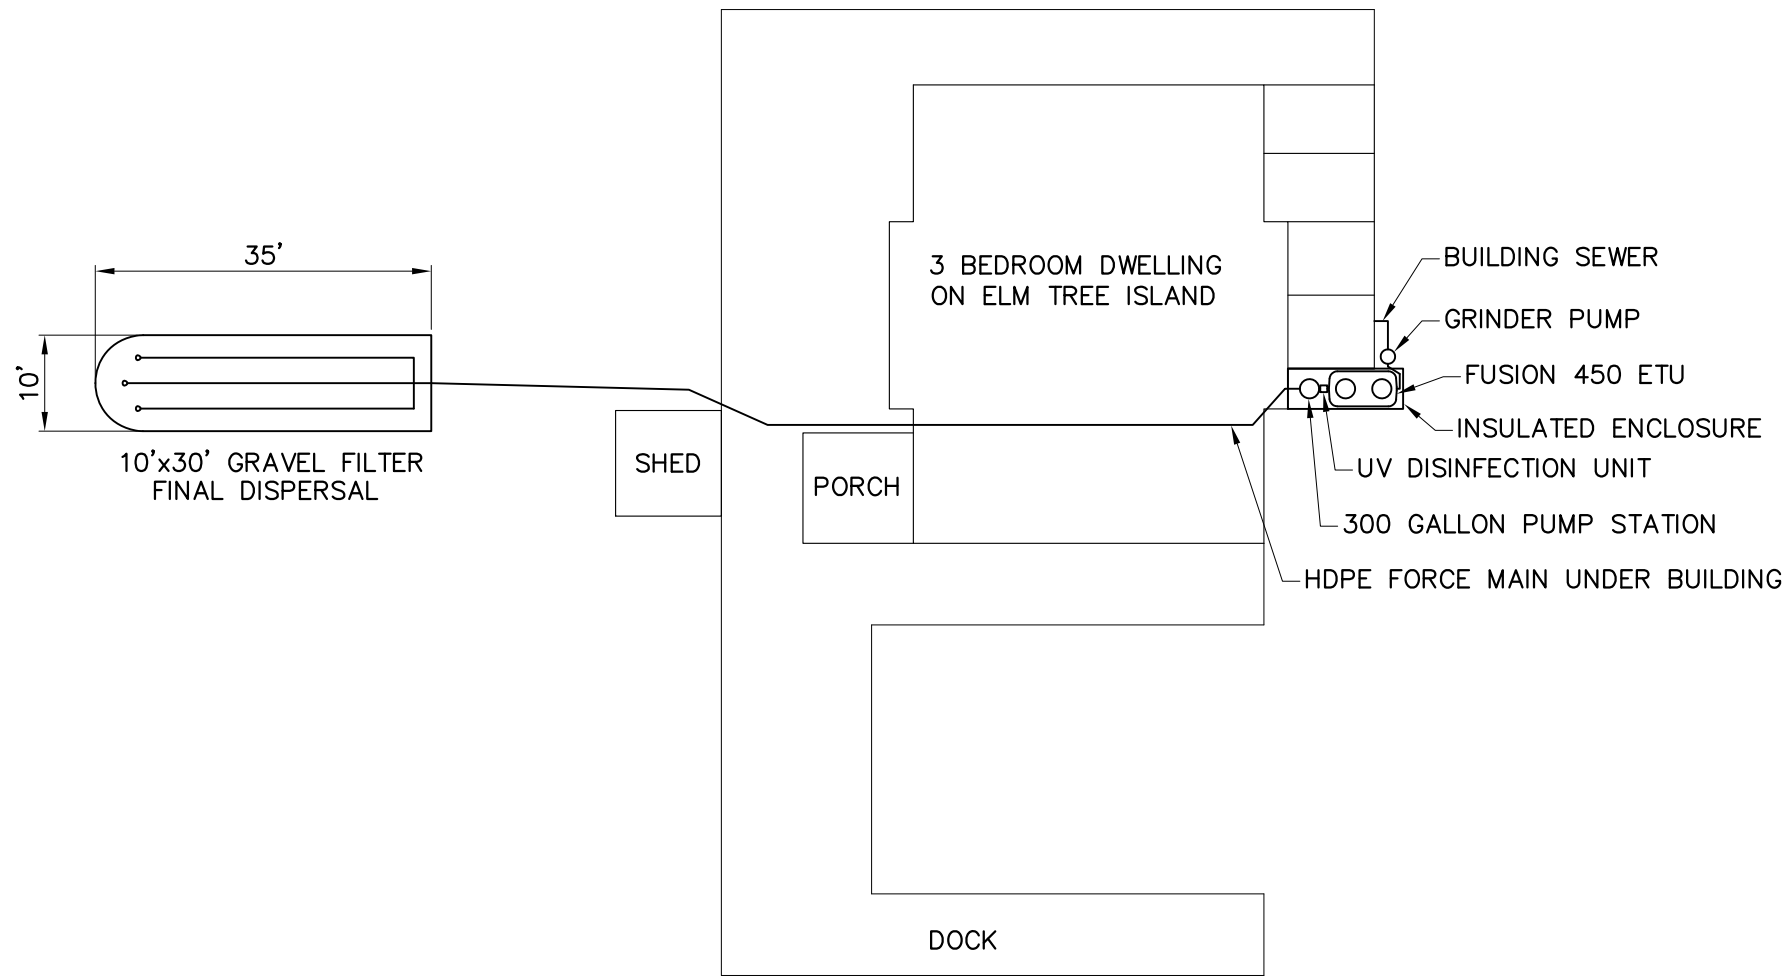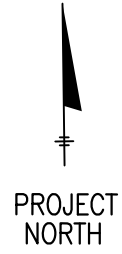

AS BUILT SEPTIC SCHEMATIC

1"=20'

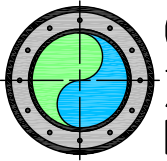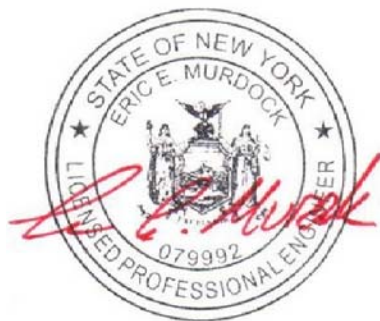

ONSITE
ENGINEERING PLLC
(315) 254-6891 - www.onsite-engineering.us

PROJECT LOCATION
YATES RESIDENCE
ELM TREE ISLAND, HAMMOND, NEW YORK 13646
TOWN OF HAMMOND - COUNTY OF ST LAWRENCE

OWNER ADDRESS
ELM TREE ISLAND
HAMMOND, NEW YORK 13646


REPLACEMENT SEPTIC PLAN

FILE NUMBER
EEM2019-060

DATE
9-23-2019


FIGURE NO.

2

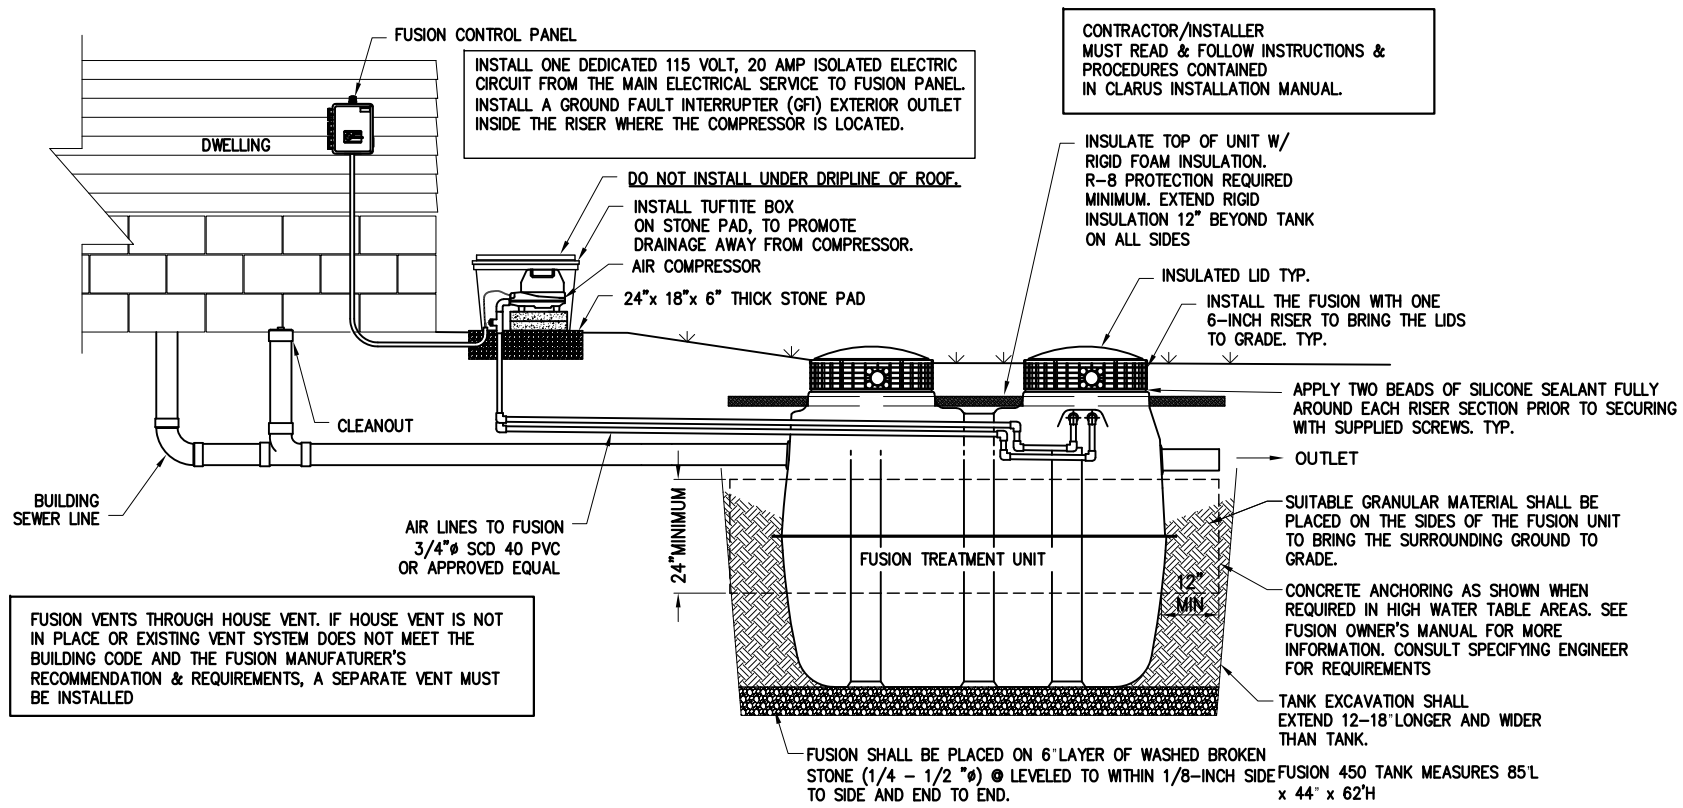


FUSION 450 - TYPICAL PROFILE

NTS

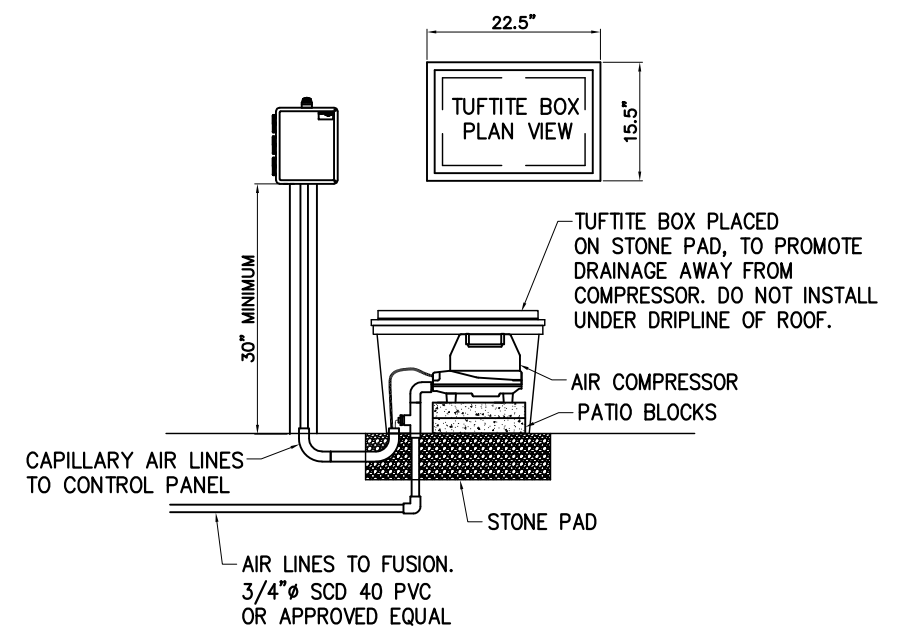


AIR COMPRESSOR INSTALLATION

NTS

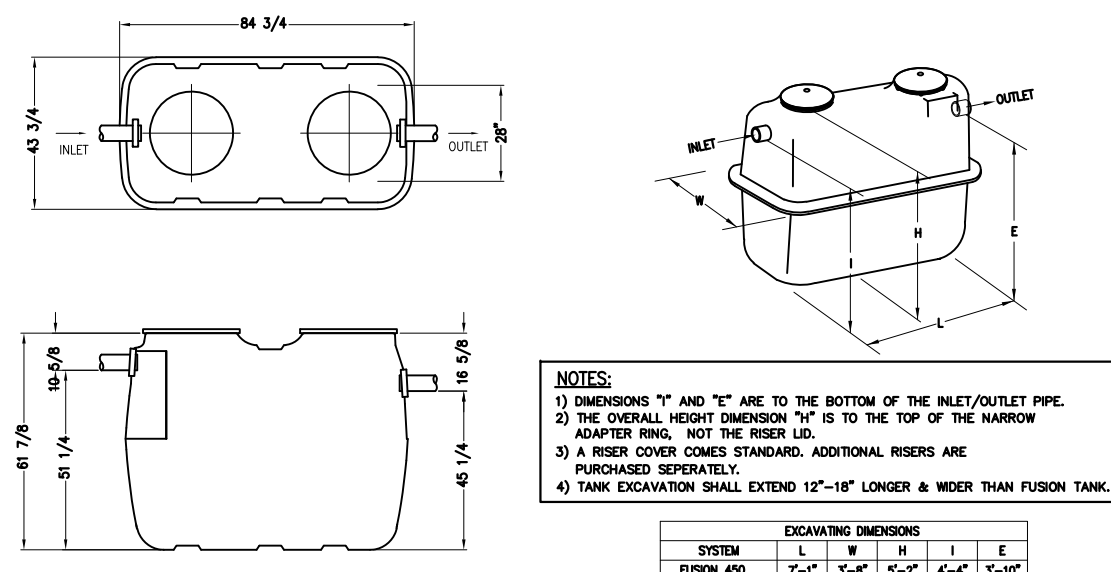

FUSION 450 - DIMENSIONS & EXCAVATION DETAILS

NTS

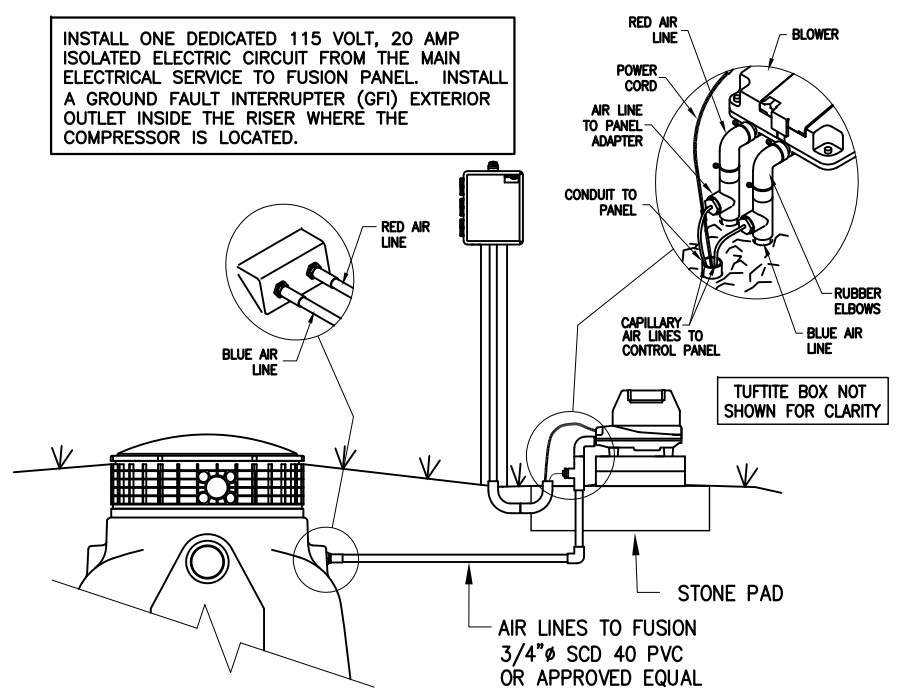

FUSION 450 - AIR COMPRESSOR DETAILS

NTS

ONSITE
 ENGINEERING PLLC
 (315) 254-6891 - www.onsite-engineering.us

PROJECT LOCATION
 YATES RESIDENCE
 ELM TREE ISLAND, HAMMOND, NEW YORK 13646
 TOWN OF HAMMOND - COUNTY OF ST LAWRENCE
 OWNER ADDRESS
 ELM TREE ISLAND
 HAMMOND, NEW YORK 13646

FILE NUMBER
 EEM2019-060
 DATE
 9-23-2019
 FIGURE NO.



SELECT DETAILS